

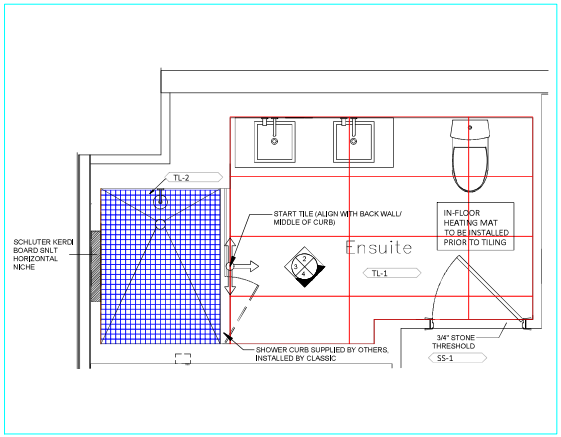



1 MASTER ENSUITE FLOOR PLAN

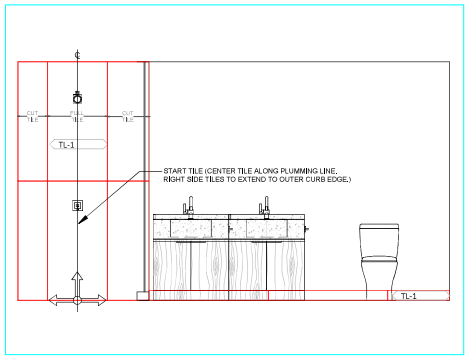


2 MASTER ENSUITE CONTROL WALL

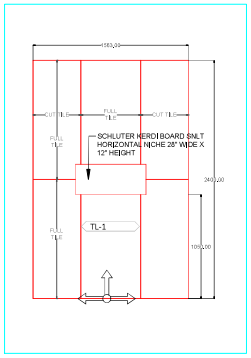


3 MASTER ENSUITE BACK WALL

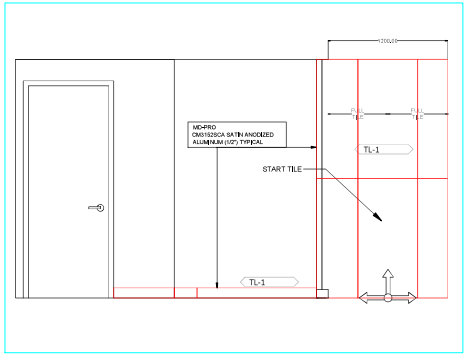


4 MASTER ENSUITE SIDE WALL

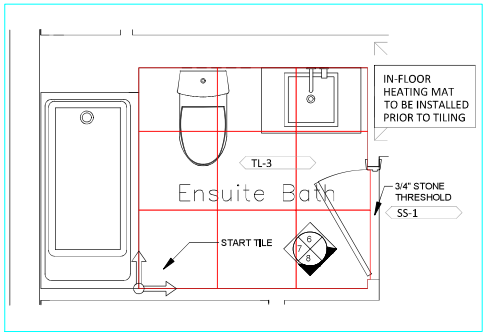


5 SMALL ENSUITE WR FLOOR PLAN

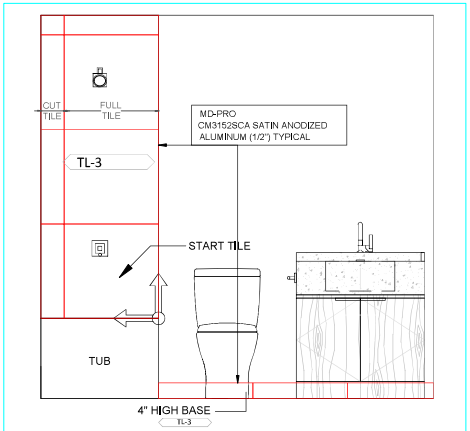


6 SMALL ENSUITE WR CONTROL WALL

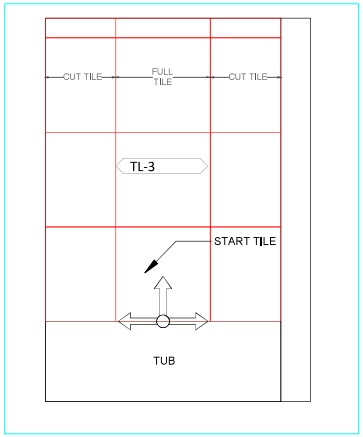


7 SMALL ENSUITE WR BACK WALL

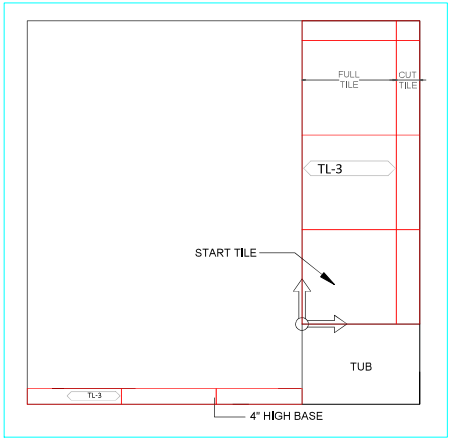

8 SMALL ENSUITE WR TUB SIDE WALL

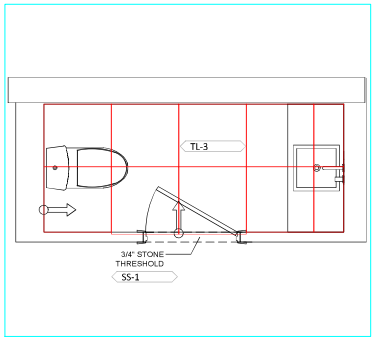

9 POWDER ROOM FLOOR PLAN

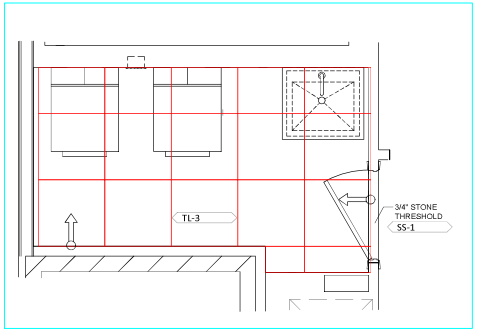

10 LAUNDRY ROOM FLOOR PLAN

FIGUR3

■ Reviewed ☐ Revise & Resubmit
☐ Reviewed as modified ☐ Not Reviewed

This review is for the sole purpose of ascertaining conformance with the general design concept. It shall not mean that figure3 approves the detail design inherent in the shop drawing or submittal, responsibility for which shall remain with the contractor submitting same, and shall not relieve the contractor of their responsibility for meeting all requirements of the contract documents. The contractor is responsible for dimensions to be confirmed and correlated at the job site, for information pertaining to fabrication or construction and installation techniques and for the coordination of the work of all sub-trades.

Project # [redacted] Received Date 07/29/2026
Reviewed By [redacted] Returned Date 07/29/2026

KEY PLAN

FLOOR FINISHES LEGEND

- TRANSITION TYPE NUMBER
- TILE SETTING OUT POINT
- INSTALL DIRECTION
- FINISHES TAG

MATERIAL LEGEND

- TL1 OLYMPIA TILE - ETERNA SERIES CALACATTA TAUPE MATTE - 600 X 1200MM - Grout - #5221 MOONBEAM
- TL2 OLYMPIA TILE - ETERNA SERIES CALACATTA TAUPE MATTE - 48 X 48MM - Grout - #5221 MOONBEAM
- TL3 OLYMPIA TILE - ETERNA SERIES CALACATTA TAUPE MATTE - 600 X 600MM - GROUT - #5221 MOONBEAM
- SS-1 STONE THRESHOLD - CAESARSTONE - QUARTZ STATUARIO MAXIMUS NO. 5031

FLOOR FINISHES NOTES

NOTE:
1- TILE GROUT JOINT IS 1.5MM (1/16") TYPICAL
2- TILE BASEBOARD IN WASHROOMS IS 4" HIGH TYPICAL
3- TILE EDGE AT TUB AND SHOWER WALLS AND BASE MD-PRO CM3152SCA SATIN ANODIZED ALUMINUM (1/2") TYPICAL

NO.	DATE	DESCRIPTION	DRAWN BY
1	JULY 28, 2026	REVISION 0	LH

PROJECT: [redacted]

REF DRAWING NO:
ARCH DRAWING (SI #9) AE1.26

SHOPDRAWING TITLE:

TILING LAYOUT
UNSOLD CROWN SUITE 1820
WASHROOMS FLOOR AND WALL ELEVATIONS

ClassicTile™ CONTRACTORS LIMITED

Classic Tile Contractors Limited
1126 Northside Rd
Burlington, ON L7M 1H4
Tel 905 335 1700
Fax 905 335 1760

SHOP DRAWING NO: [redacted]SD-04

PROJECT NORTH